


THE DRAWING AND DESIGN HEREIN SHALL NOT BE DUPLICATED, USED OR DISCLOSED TO OTHERS FOR PROCUREMENT OR OTHER PURPOSE (EXCEPT AS OTHERWISE AUTHORIZED BY CONTRACT) WITHOUT WRITTEN PERMISSION OF SOMERS BUILDING TECHNOLOGIES, INC., FIRE SAFETY DIVISION. ALL OTHER REPRODUCTIONS SHALL BEAR THIS NOTICE.

## REVISIONS

No.	Revision	By	Date	Appr.
△	REVISED PER FIRE MARSHAL'S COMMENTS DATED 02/12/09	JPM	2/27/09	KW
	AS-BUILT	JPM	8/10/09	KW

AS BUILT

C-10 APPROVAL STAMP:

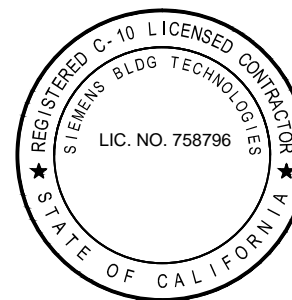

ENGINEERING CONSULTANTS:

CUSTOMER'S NAME & ADDRESS

PRODUCT MANUFACTURER:

**Siemens Building Technologies, Inc.**  
Fire Safety Division

25821 Industrial Boulevard, Suite 300  
Hayward, California 94545-2991  
Tel (510) 783-6000 Fax (510) 293-2100  
California State C10 License No. 758796  
U.L. Certificate ID No. 324787-001

JOB NAME & LOCATION (STREET ADDRESS)

**LAWRENCE BERKELEY  
NATIONAL LABORATORY**

**BERKELEY LAB  
GUEST HOUSE**

Berkeley, California

SHEET CONTENTS:

**FIRE ALARM PLAN -  
LEVEL ONE**

INSTALLATION TYPE

- ☒ NEW INSTALLATION  
☐ DESIGN/BUILD  
☐ PER CONTRACT DOCUMENT  
☐ EXISTING BASE JOB # N/A  
☐ OTHERS

SYSTEM SALES REP.: Kevin Waxman

PROJECT MANAGER: Mark Millard

DRAWN BY: John Paul Minas


CAD FILENAME: FA-08

SCALE: As Shown

DATE DRAWN: January 12, 2009 PLOT DATE: November 04, 2013

SHEET **FA-08** JOB NUMBER **440P-048653**

DRAWING NO. **6B23E010**

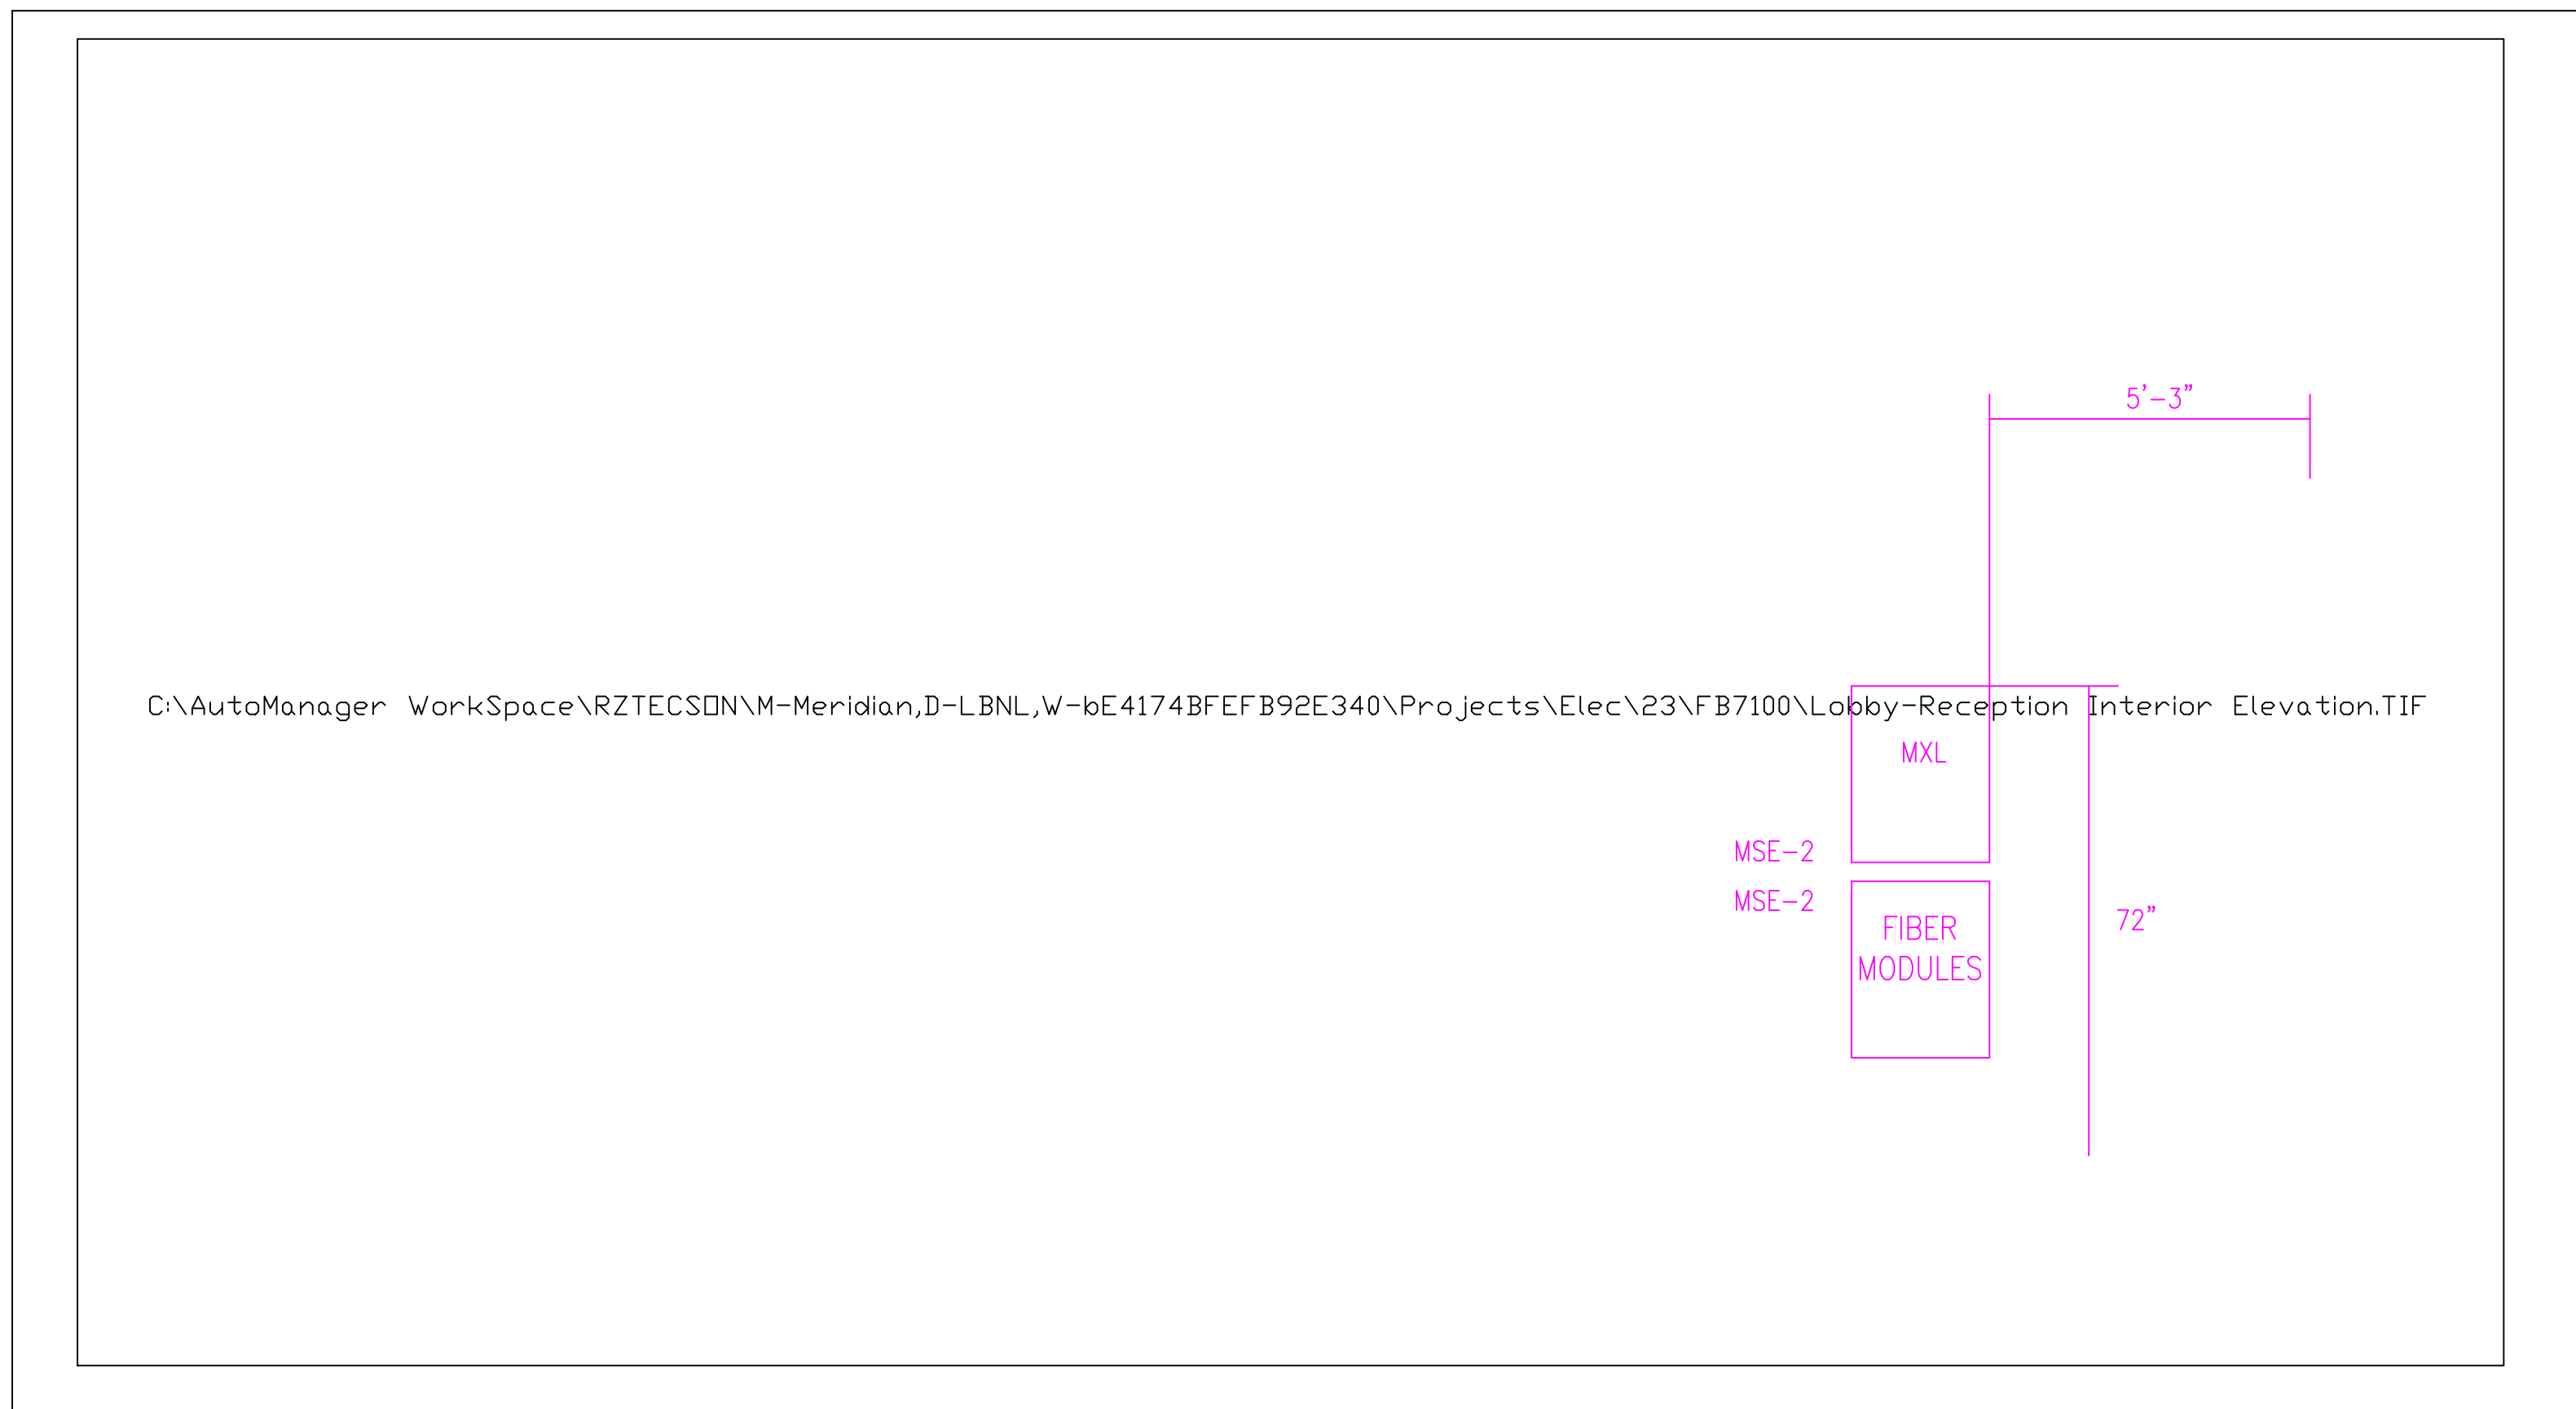

## DETAIL "A"

Not to Scale

